


3300' EAST OF DATE
704
4004

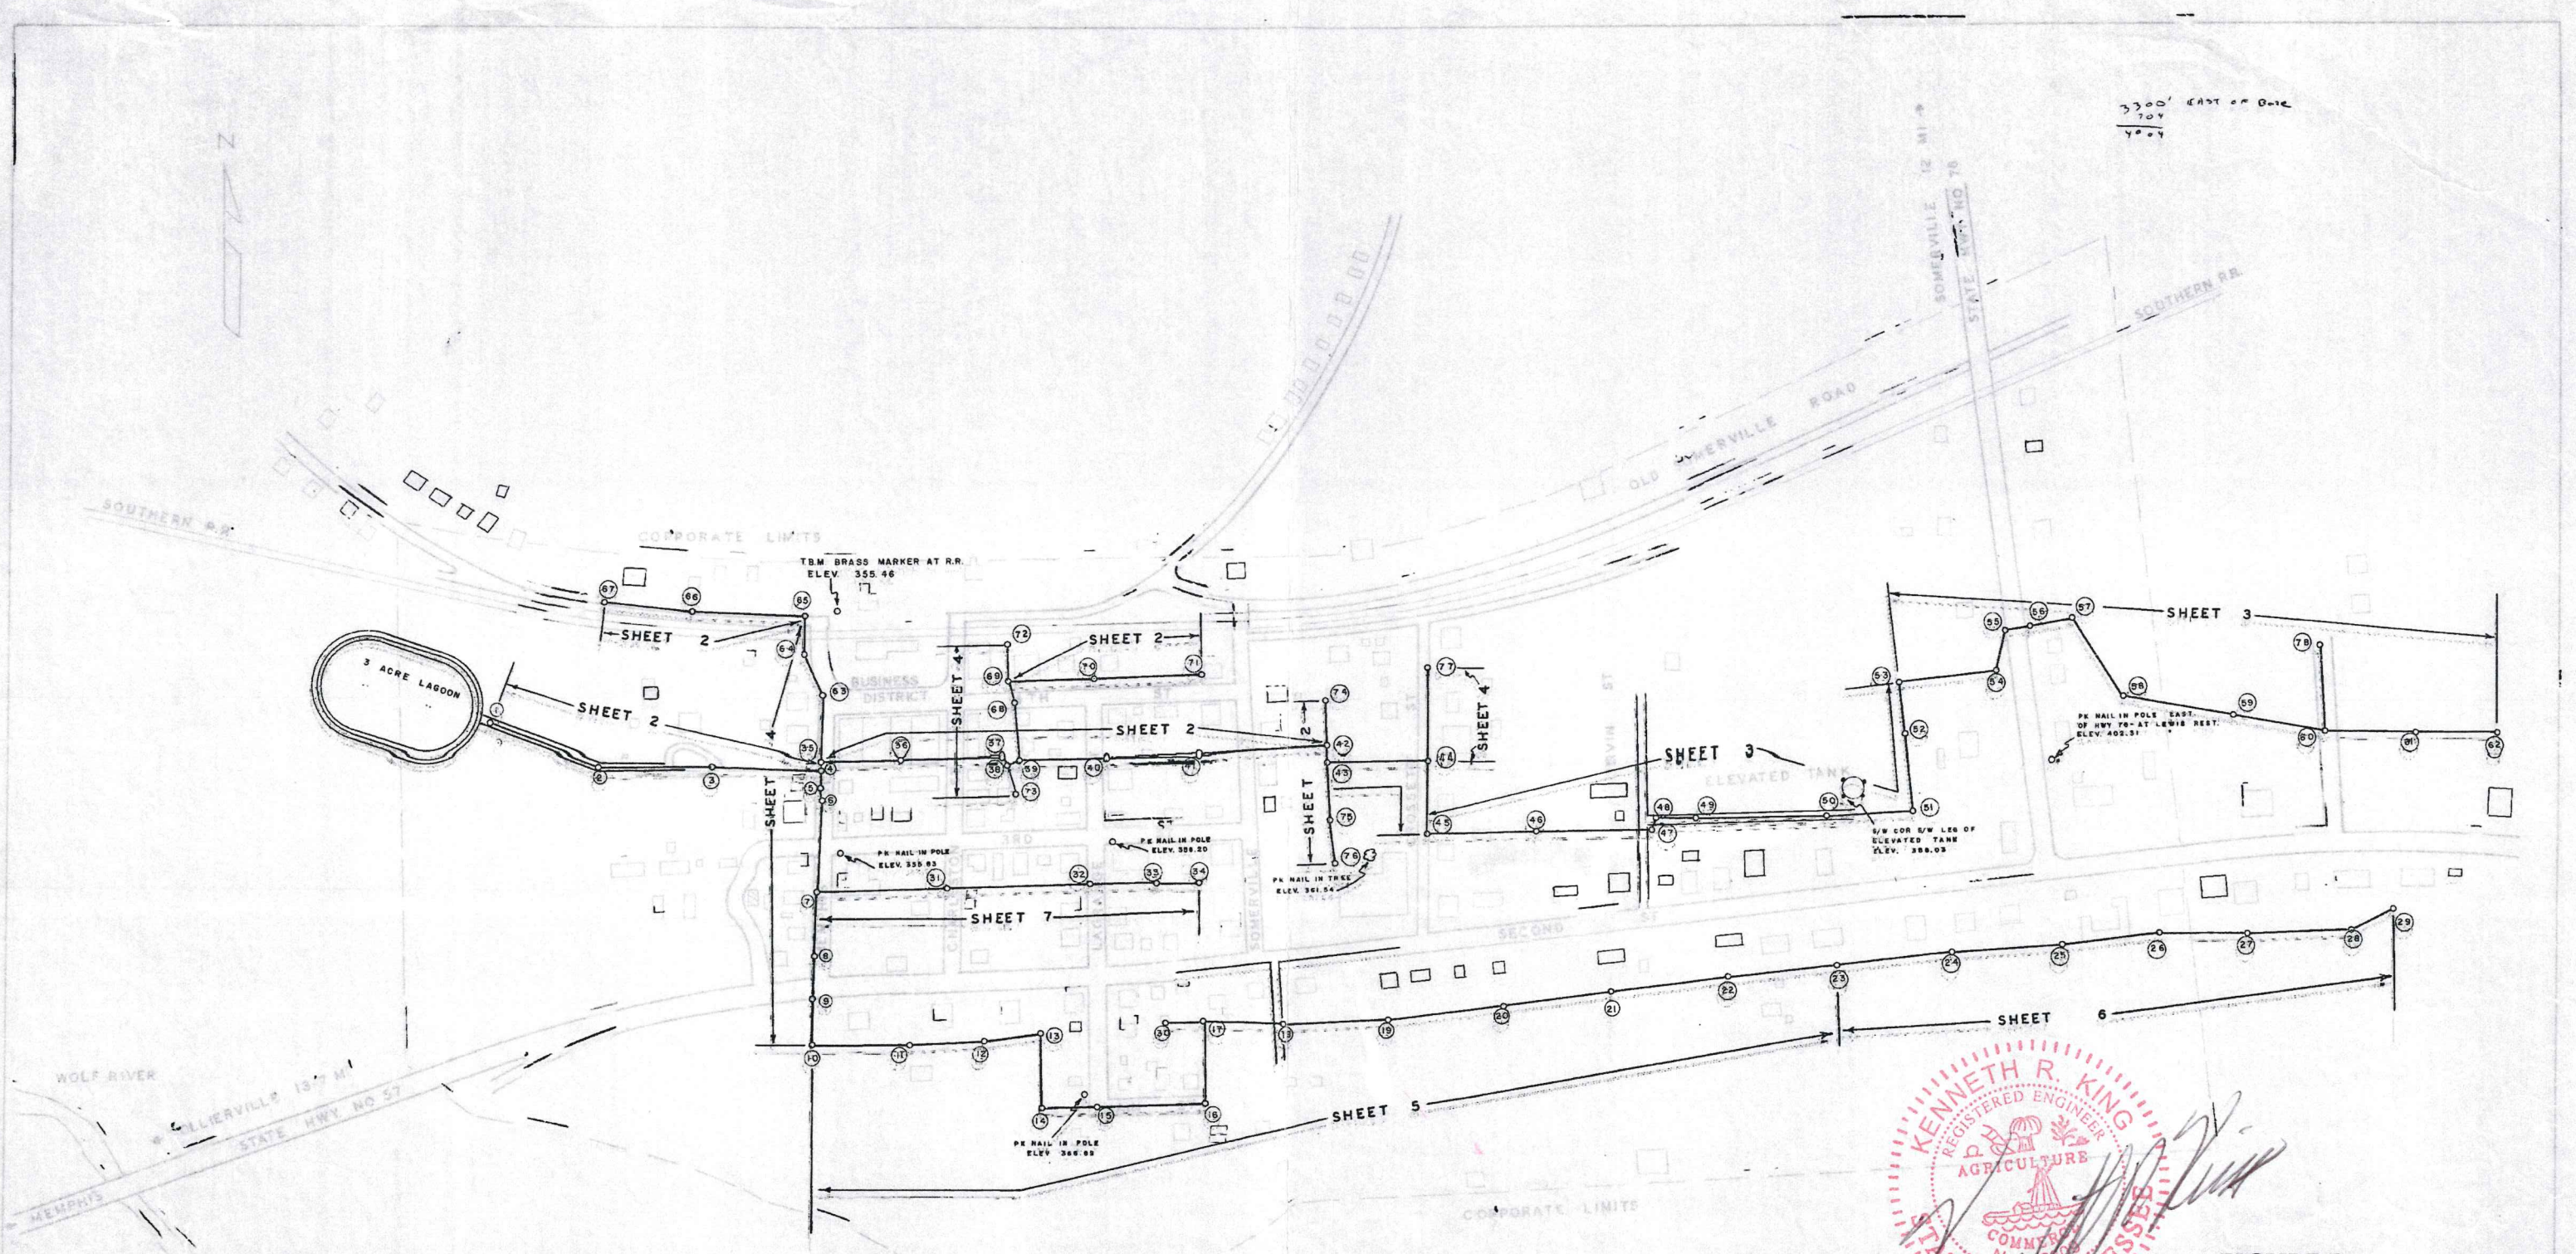

NOTE
 ASPHALT PATCHING AND PAVING
 TO BE DONE BY OTHERS AND NOT
 IN THIS CONTRACT



FIGURE D
 AS BUILT
 MASTER PLAN
 SHEET 1008

REVISED: 7-24-64

PROJECT NO. APW - TENN-816
 APW - TENN-125

SANITARY SEWERS
 MOSCOW, TENNESSEE
 SCALE: 1" = 20'
 DATE: 8-9-63
 RICHARD L. KING
 CONSULTING ENGINEER
 MEMPHIS, TENNESSEE